



MICHAEL S. LITWIN
& MARY J. BLIZZARD

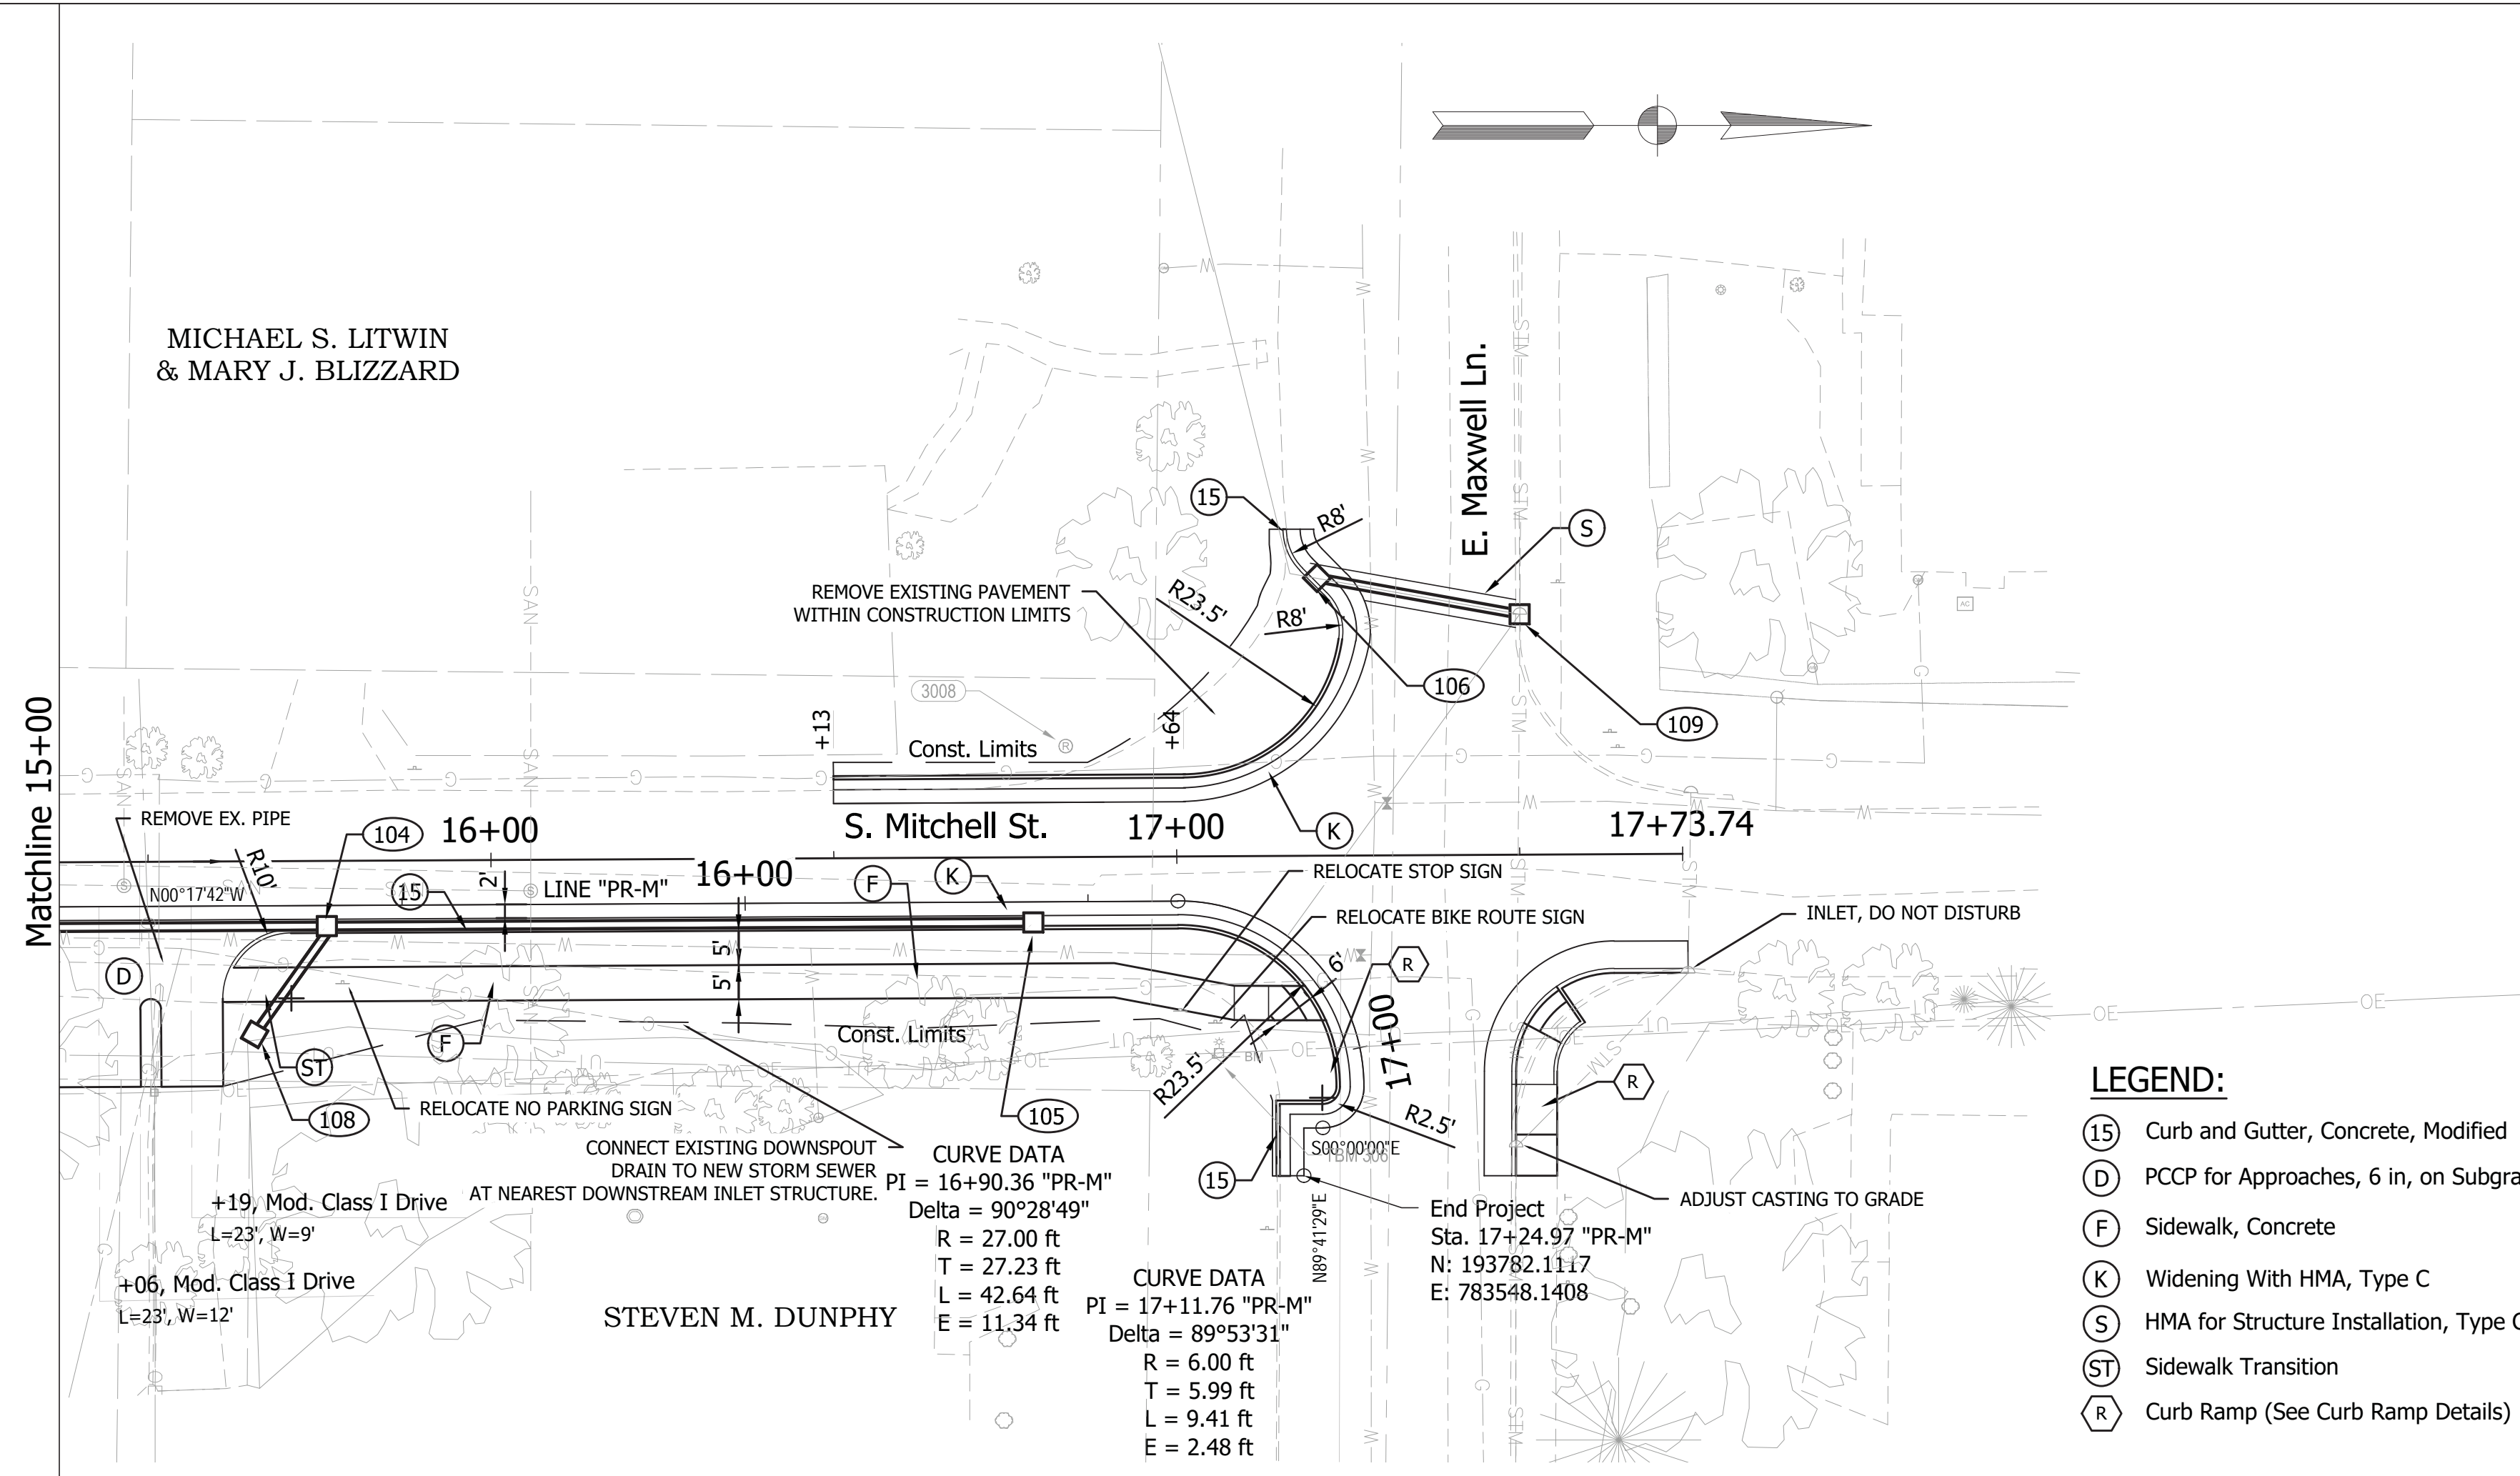


LEGEND:

- (15) Curb and Gutter, Concrete, Modified
- (D) PCCP for Approaches, 6 in, on Subgrade Treatment Type II
- (F) Sidewalk, Concrete
- (K) Widening With HMA, Type C
- (S) HMA for Structure Installation, Type C
- (ST) Sidewalk Transition
- (R) Curb Ramp (See Curb Ramp Details)

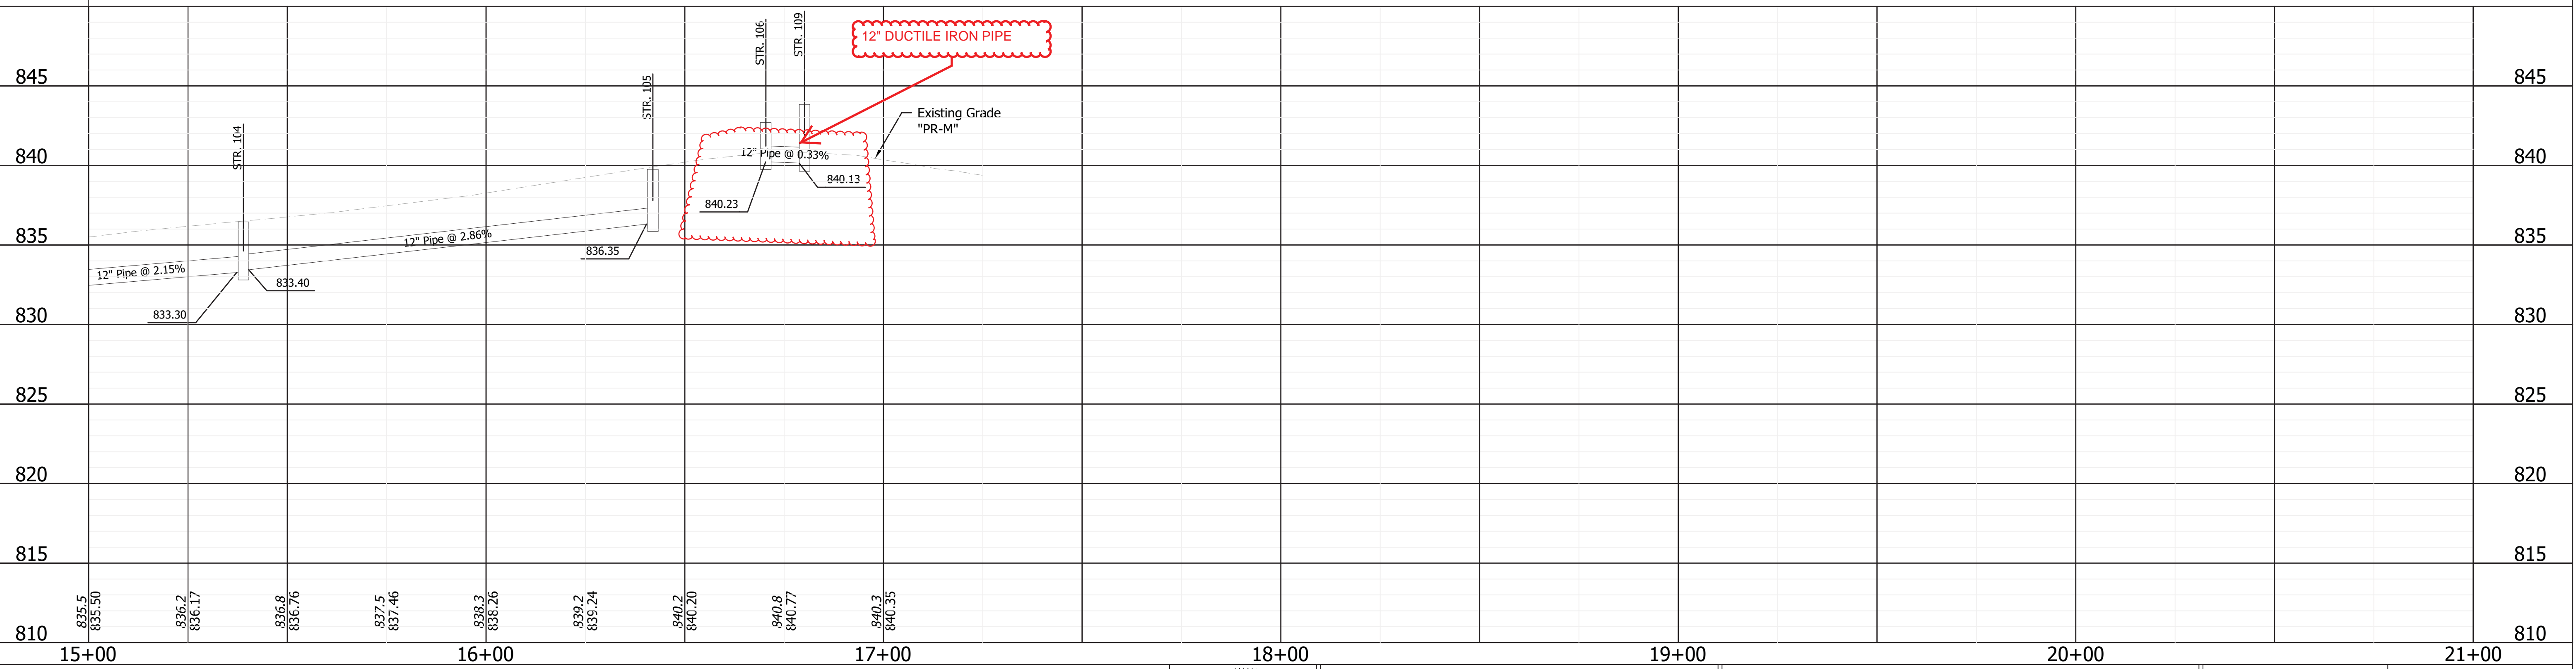

p:\2016\160076 mitchell st. & walnut st. sidewalk design\Plans\Construction\Plans\Mitchell\St_Mitch_Plan&Profile 01.dwg

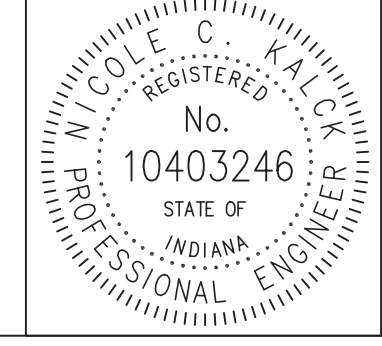

RECOMMENDED FOR APPROVAL: *Nicole C. Kalkbrenner*
DESIGN ENGINEER DATE: 10/30/2018
DESIGNED: AJS DRAWN: LAB
CHECKED: NCK CHECKED: NCK

CITY OF BLOOMINGTON, INDIANA
PLAN AND PROFILE

| | |
|-------------|-------------|
| SCALE | BRIDGE FILE |
| 1"=20' | DESIGNATION |
| VERT. SCALE | |
| 1"=5' | |
| SURVEY BOOK | SHEETS |
| | 6 of 16 |
| CONTRACT | PROJECT |